

Production			
PRELIMINARY 12" GAS/CONDENSATE PIPELINE BLK 62-Prop 48" Caisson near WELL #1 to BLK 44 TIE-IN TO EXISTING 36" WEST CAMERON AREA GULF OF MEXICO			
FUGRO CHANCE INC. <small>328 Balfour Dr. Lafayette, Louisiana 70506-3001 (337) 237-1500</small>			
GEODETIC DATUM: NAD83 PROJECTION: LOUISIANA SOUTH GRID UNITS: US SURVEY FEET		SCALE IN FEET 0 30,000'	
Job No.: 08-2641	Date: 2/02/08	Drwn: VAG	Chart: Of:
Dwgfile: H:\2006\082641\CAD\Marine\VICINITY			1 3

CALCASIEU PASS SAFETY FAIRWAY

MMS SEG. NO. 15235

PRELIMINARY 12" GAS/COND PIPELINE

67+99.55
WEST CHANNEL SHOULDER
(REFERENCE ONLY)

Lat. 29° 37' 55.320"N
Lon. 93° 19' 25.251"W

WC62

OCS-G-25872

El Paso

59+12.36
CHANNEL CROSSING

X= 1,368,537.54'
Y= 356,293.57'
Lat. 29° 37' 53.001"N
Lon. 93° 19' 15.559"W

CALCASIEU PASS NORTH ANCHORAGE AREA

GRID NORTH

141+44.08
FAIRWAY CROSSING

X= 1,360,627.78'
Y= 358,565.54'
Lat. 29° 38' 14.123"N
Lon. 93° 20' 45.624"W

68+23.86
CHANNEL CROSSING

X= 1,367,660.76'
Y= 356,540.07'
Lat. 29° 37' 55.290"N
Lon. 93° 19' 25.541"W

58+88.05
EAST CHANNEL SHOULDER
(REFERENCE ONLY)

Lat. 29° 37' 52.838"N
Lon. 93° 19' 15.323"W

06+91.49
FAIRWAY CROSSING

X= 1,373,549.36'
Y= 354,839.47'
Lat. 29° 37' 39.464"N
Lon. 93° 18' 18.495"W

BEGIN BURIAL SURVEY


X= 1,374,143.60'
Y= 354,656.74'
Lat. 29° 37' 37.757"N
Lon. 93° 18' 11.727"W

STATION	MUDLINE	TOP OF PIPE	BURIAL DEPTH
58+88.05	-41' 6"	-53' 3"	11' 9"
59+49.79	-42' 8"	-53' 2"	11' 6"
60+05.24	-43' 6"	-55' 3"	11' 9"
60+68.67	-44' 4"	-55' 9"	11' 5"
61+52.38	-45' 6"	-55' 4"	10' 10"
64+01.33	-46' 4"	-56' 10"	10' 6"
65+20.12	-45' 7"	-56' 9"	11' 2"
65+63.44	-44' 9"	-55' 7"	10' 10"
66+43.90	-42' 6"	-53' 6"	11' 0"
67+24.81	-38' 6"	-49' 4"	10' 10"
67+99.55	-36' 0"	-45' 2"	9' 2"

DREDGED MATERIAL
DISPOSAL SITE

PLAN

SCALE IN FEET
0 2,000'

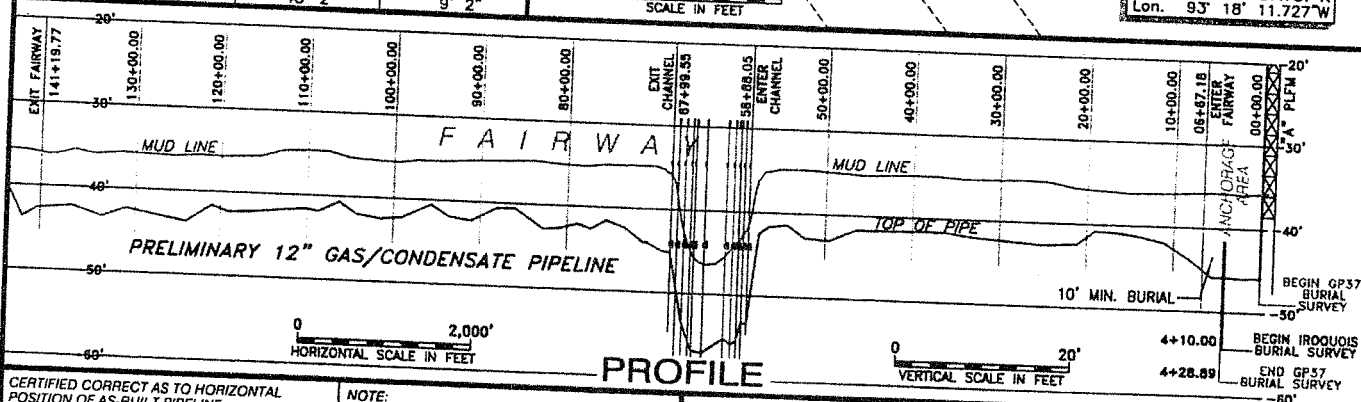

PROFILE

eipaso Production

**AS-BUILT
12" GAS/COND PIPELINE**
BLOCK 62
WEST CAMERON AREA
GULF OF MEXICO



Global Industries, Ltd.

FUGRO CHANCE INC.



GEODETIC DATUM: NAD27
PROJECTION: LOUISIANA SOUTH
GRID UNITS: US SURVEY FEET

SCALE
IN FEET 0 2,000'

Job No.: 06-2641

Date: 5/09/06

Drwn: VAG

Chart: Of:

DIGITAL COPY
ORIGINAL PLAT SIGNED 5/09/06

REG. PROFESSIONAL LAND SURVEYOR NO. 4401
STATE OF LOUISIANA

Printed: 5/9/06

Dwgfile: H:\2006\062641\CAD\Marine\062641_8x11

1 1

