

PROJECT LOCATION:
 X = 3,554,033.82 (NAD 83)
 Y = 560,109.86 (NAD 83)
 LAT: 30°02'14.51" (NAD 83)
 LONG: 90°28'11.63" (NAD 83)

PROJECT VICINITY

THESE PLATS ARE TO BE USED EXCLUSIVELY FOR THE ACQUISITION OF REGULATORY PERMITS.

NO.	DATE	REVISION
-----	------	----------


VICINITY MAP

ARCELOR MITTAL LAPLACE, LLC

DOCUMENTATION REGARDING BANK STABILITY RECONSTRUCTION ALONG THE MISSISSIPPI RIVER
 AND SUPPLEMENTAL DOCUMENTATION REGARDING EXISTING DEMOLITION WORK AREA
 LOCATED IN SECTION 39, T12S-R07E
 ST. JOHN THE BAPTIST PARISH, LOUISIANA



T. BAKER SMITH
 PROFESSIONAL CONSULTANTS SINCE 1913
 (985) 868-1050 www.tbsmith.com

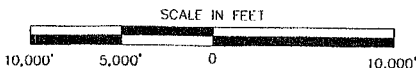

FILE:

SHEET	1	OF	12
DRAWN BY:	SPM		
APPROVED BY:	KJB		
SCALE:	1" = 10,000'		
DATE:	07/20/2011		
JOB NUMBER:	2011.0067		

MHW = +12.0'
MLW = +8.0'

ST. JOHN THE BAPTIST PARISH, LOUISIANA

PARISH HWY. 3217

EXISTING ACCESS ROAD

PREVIOUSLY PERMITTED WORK
AREA (200' x 600') DIGITIZED FROM
PERMIT NUMBERS P981515 & MVN
1999-531 CT

WORK AREA

EXISTING BUILDING

EXISTING FACILITY

EAST 5TH ST./ PARISH HWY. 628

AS-BUILT EXCAVATION

BARGE PULL-UP AREAS

MISSISSIPPI RIVER

EXISTING FACILITY

EXISTING FACILITY

SPOIL PLACEMENT AREA
(0.29± ACRES)

EXISTING RAILROAD

257'
57'
G
G

LEGEND:

⇌ DENOTES ACCESS ROUTE

REVISED SPOIL PLACEMENT AREA AND ADDED CROSS-SECTION.

REVISION

1 07/20/2011
NO. DATE

PLAN VIEW

ARCELOR MITTAL LAPLACE, LLC

DOCUMENTATION REGARDING BANK STABILITY RECONSTRUCTION ALONG THE MISSISSIPPI RIVER
AND SUPPLEMENTAL DOCUMENTATION REGARDING EXISTING DEMOLITION WORK AREA
LOCATED IN SECTION 39, T12S-R07E

ST. JOHN THE BAPTIST PARISH, LOUISIANA

THESE PLATS ARE TO BE USED EXCLUSIVELY FOR
THE ACQUISITION OF REGULATORY PERMITS.

NOTES:



T. BAKER SMITH
PROFESSIONAL CONSULTING ENGINEER
(985) 888-1050 www.tbsmith.com

SCALE IN FEET




SHEET 2 OF 12
DRAWN BY: SPM
APPROVED BY: KJB
SCALE: 1" = 600'
DATE: 07/20/2011
JOB NUMBER: 2011.0067

FILE:

ST. JOHN THE BAPTIST PARISH, LOUISIANA

MHW = +12.0'
MLW = +8.0'

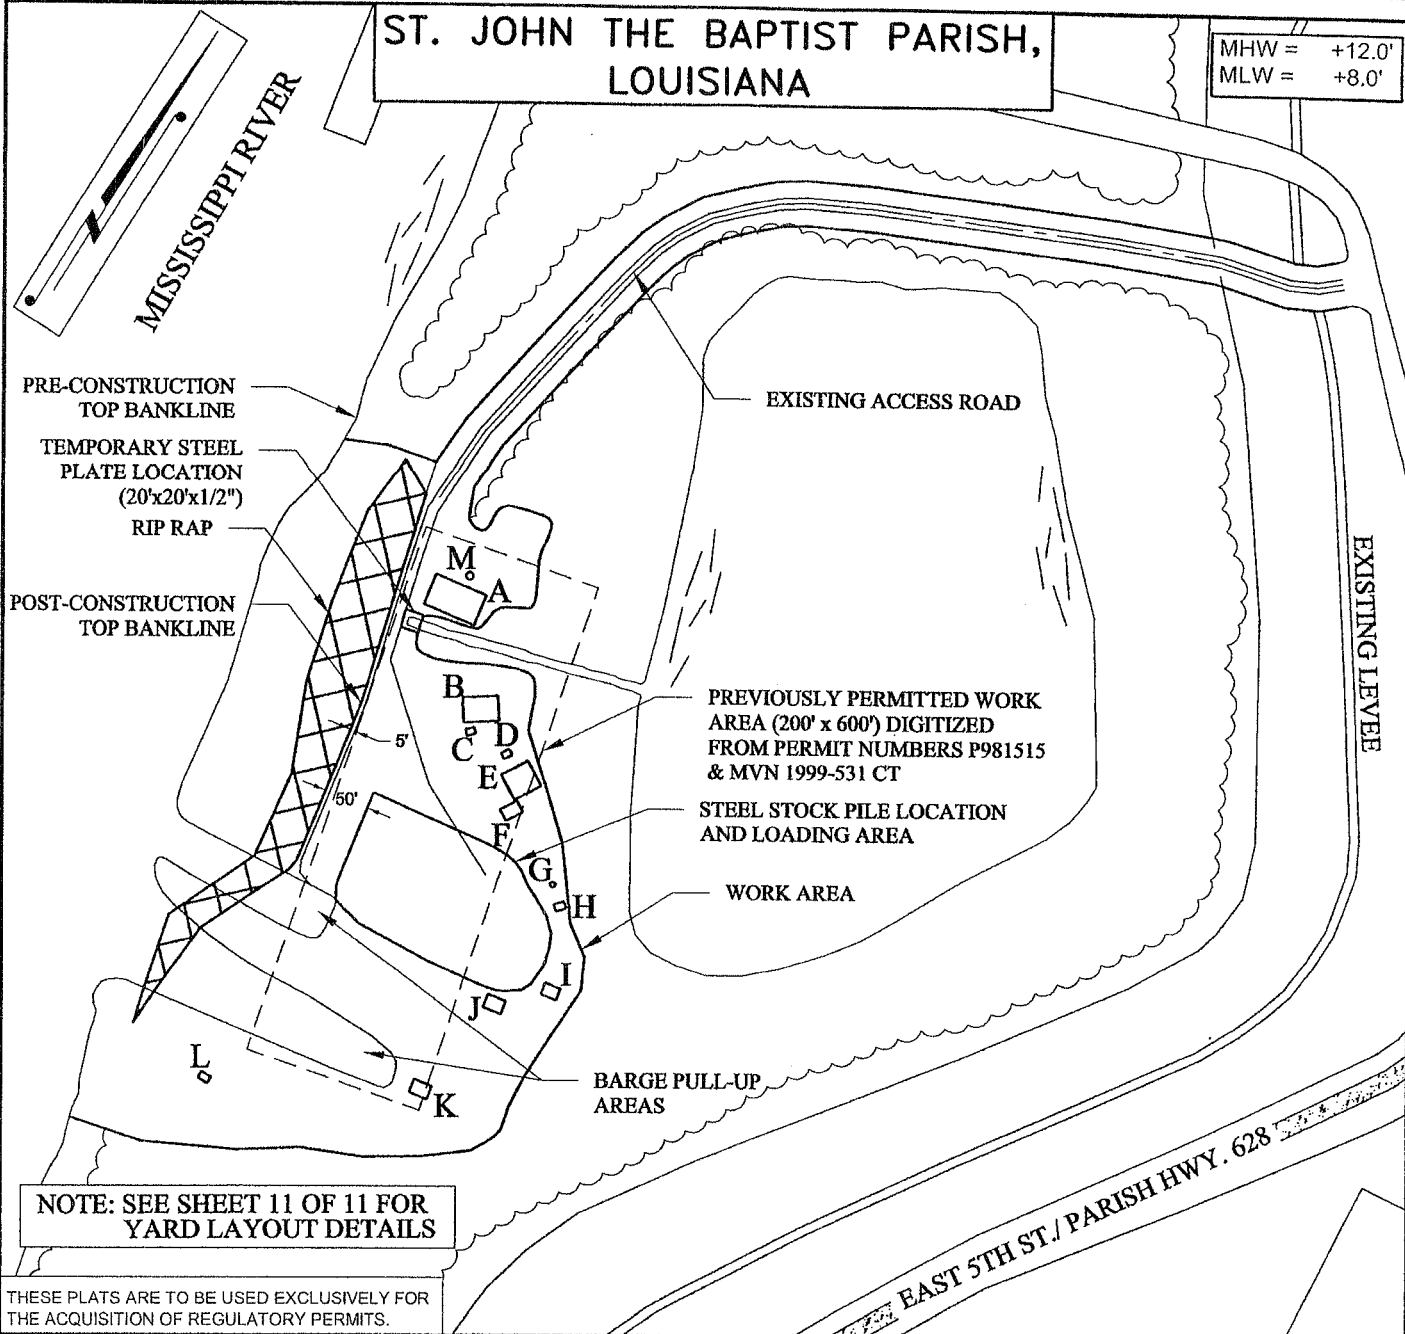

NO.	DATE	REVISION
-----	------	----------


YARD LAYOUT

ARCELOR MITTAL LAPLACE, LLC

DOCUMENTATION REGARDING BANK STABILITY RECONSTRUCTION ALONG THE MISSISSIPPI RIVER
AND SUPPLEMENTAL DOCUMENTATION REGARDING EXISTING DEMOLITION WORK AREA
LOCATED IN SECTION 39, T12S-R07E
ST. JOHN THE BAPTIST PARISH, LOUISIANA



T. BAKER SMITH
PROFESSIONAL CONSULTANTS SINCE 1913
(985) 868-1050 www.tbsmith.com

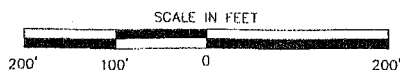


FILE:

SHEET	3	OF	12
DRAWN BY:	SPM		
APPROVED BY:	KJB		
SCALE:	1" = 200'		
DATE:	07/20/2011		
JOB NUMBER:	2011.0067		

MHW = +12.0'
MLW = +8.0'

ST. JOHN THE BAPTIST PARISH, LOUISIANA

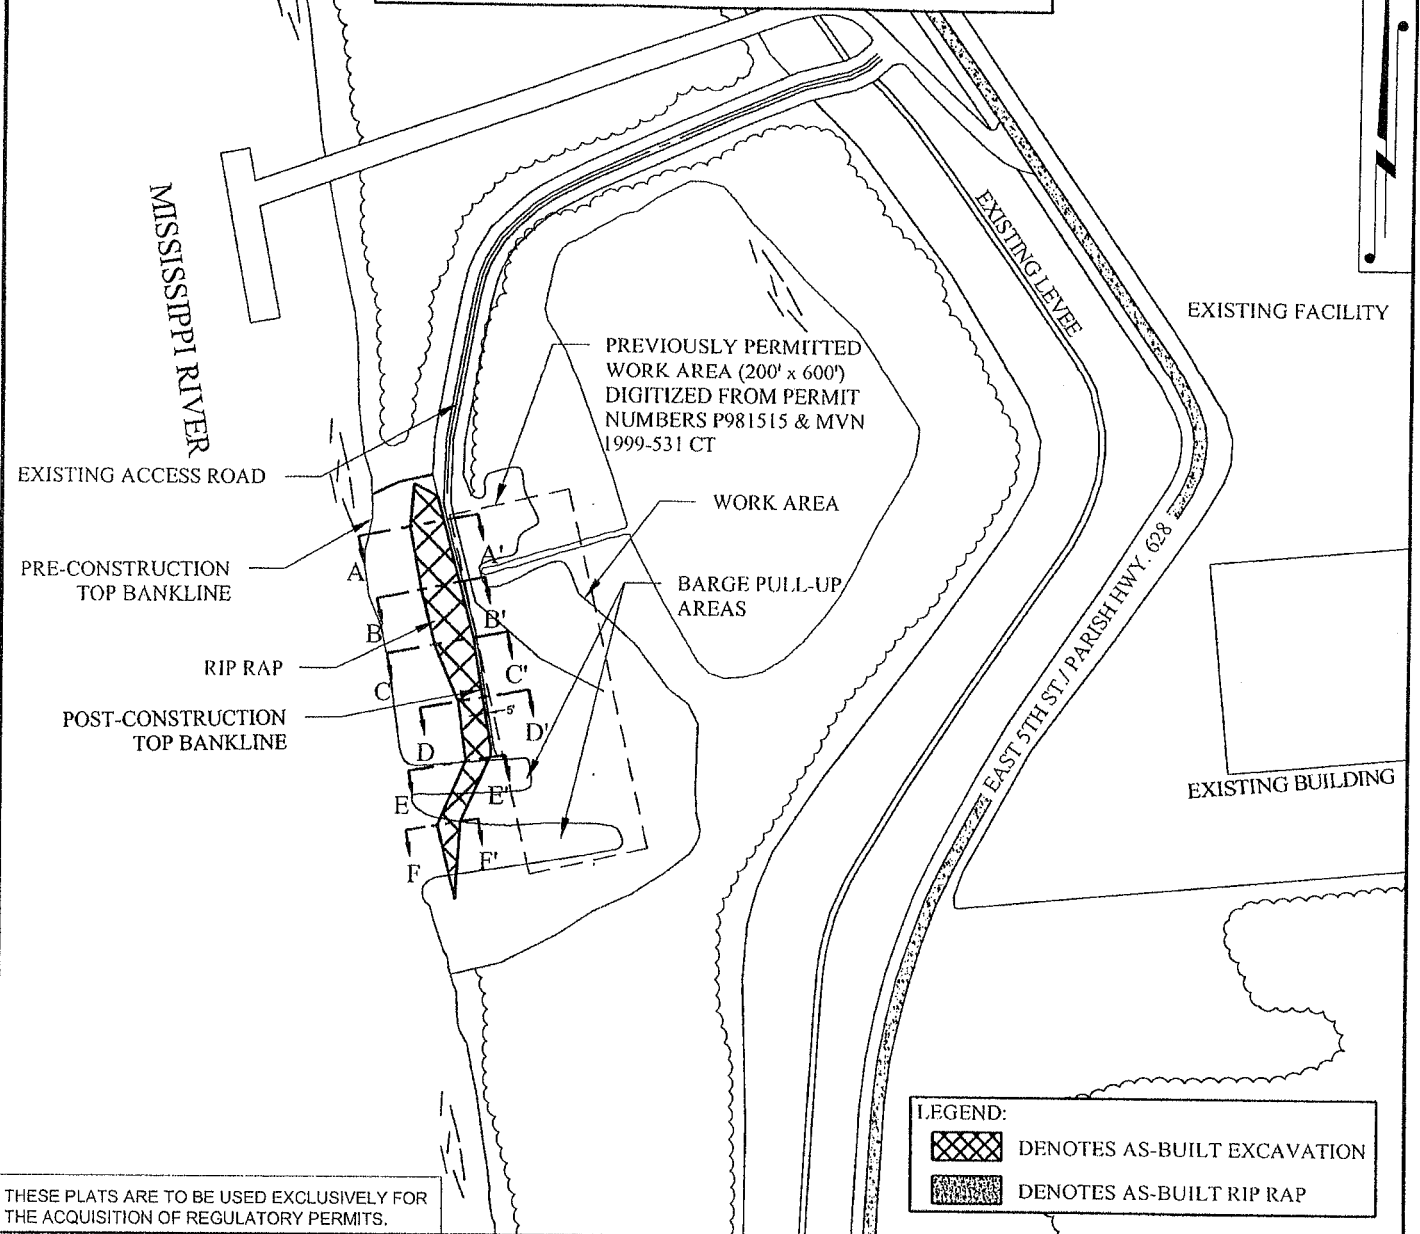

THESE PLATS ARE TO BE USED EXCLUSIVELY FOR
THE ACQUISITION OF REGULATORY PERMITS.

NO.	DATE	REVISION


PLAN VIEW

ARCELOR MITTAL LAPLACE, LLC

DOCUMENTATION REGARDING BANK STABILITY RECONSTRUCTION ALONG THE MISSISSIPPI RIVER
AND SUPPLEMENTAL DOCUMENTATION REGARDING EXISTING DEMOLITION WORK AREA
LOCATED IN SECTION 39, T12S-R07E
ST. JOHN THE BAPTIST PARISH, LOUISIANA





T. BAKER SMITH
PROFESSIONAL CONSULTANTS SINCE 1913
(985) 888-1050 www.tbsmith.com

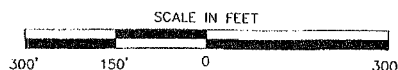

FILE:

SHEET	4	OF	12
DRAWN BY:	SPM		
APPROVED BY:	KJB		
SCALE:	1"= 300'		
DATE:	07/20/2011		
JOB NUMBER:	2011.0067		

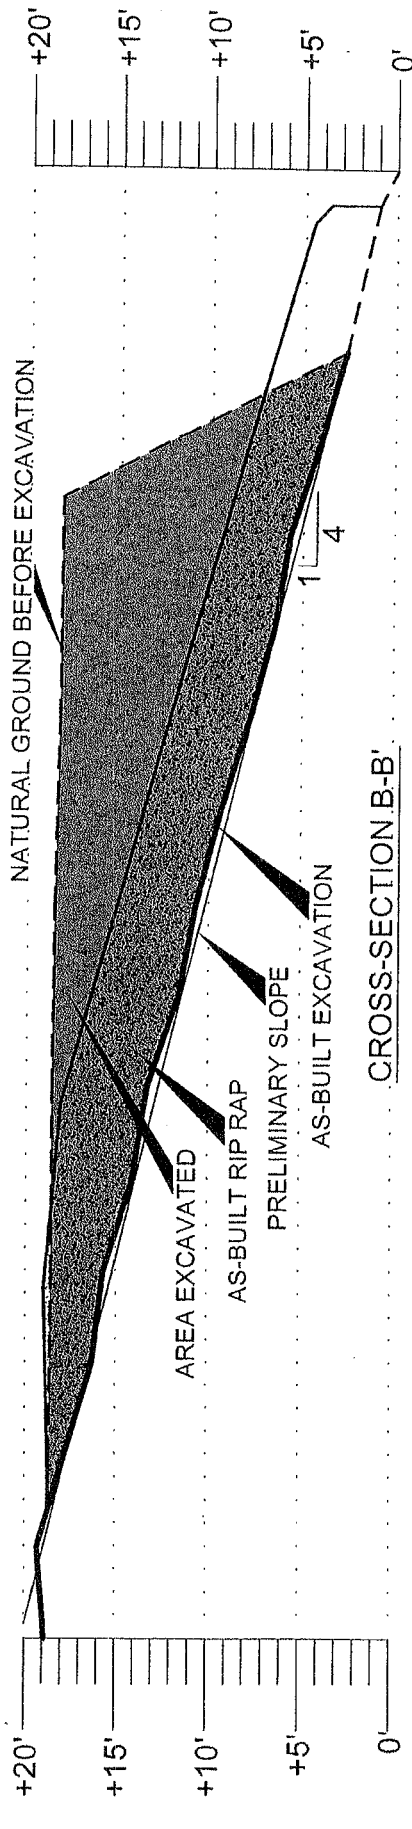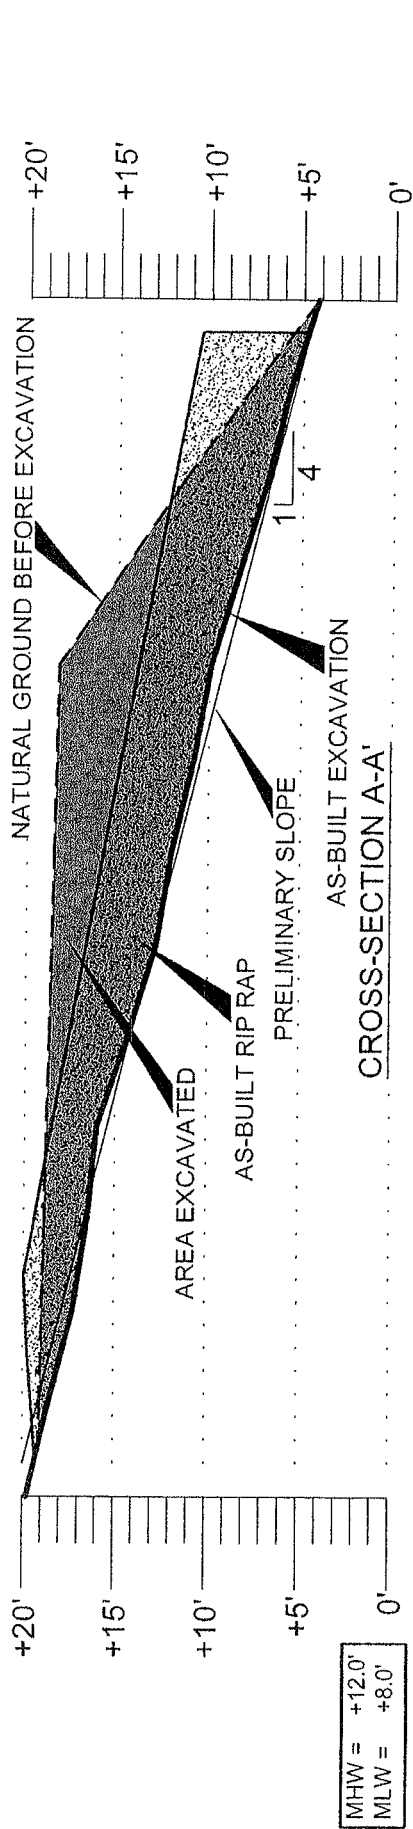

REVISION

PROFILE VIEW

ARCELOR MITTAL LAPLACE, LLC


DOCUMENTATION REGARDING BANK STABILITY RECONSTRUCTION ALONG THE MISSISSIPPI RIVER
AND SUPPLEMENTAL DOCUMENTATION REGARDING EXISTING DEMOLITION WORK AREA
LOCATED IN SECTION 39, T12S-R07E
ST. JOHN THE BAPTIST PARISH, LOUISIANA

THESE PLATS ARE TO BE USED EXCLUSIVELY FOR
THE ACQUISITION OF REGULATORY PERMITS.

NOTES:




T. BAKER SMITH
PROFESSIONAL ENGINEER
(985) 886-1050 www.tbsmith.com

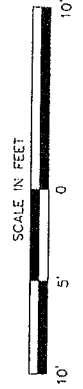

SHEET	5	OF	12
DRAWN BY:	SPM		
APPROVED BY:	KJB		
SCALE:	1"= 10'		
DATE:	07/20/2011		
JOB NUMBER:	2011.0067		

FILE:

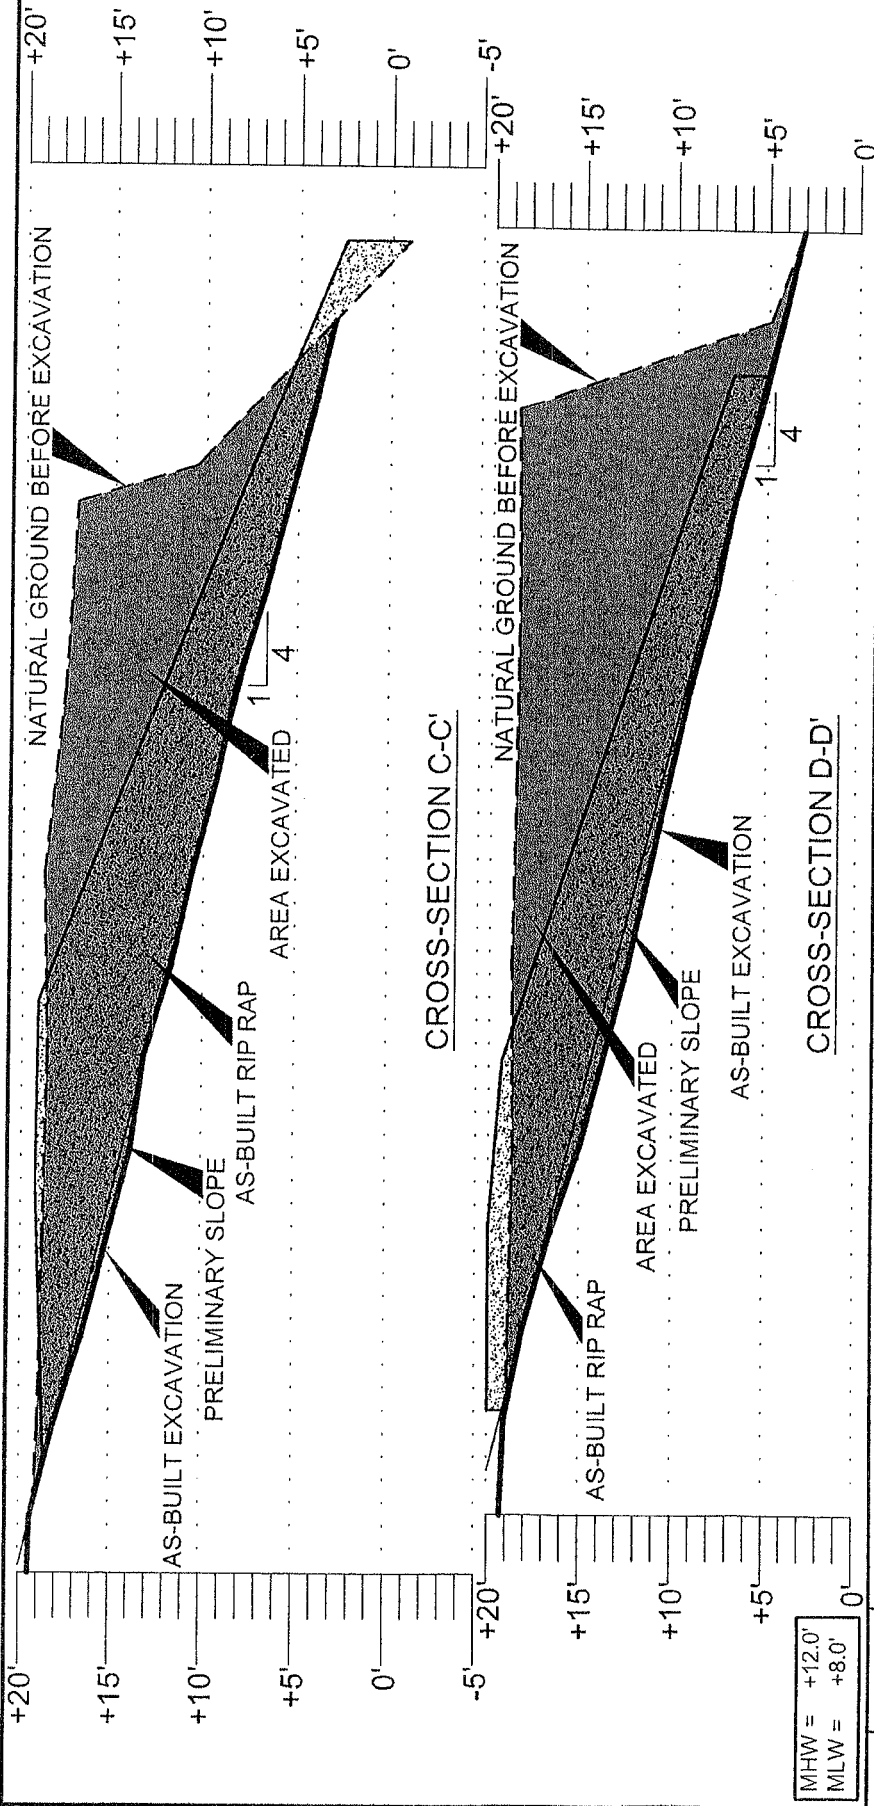

MHW = +12.0'
MLW = +8.0'

REVISION

PROFILE VIEW

ARCELOR MITTAL LAPLACE, LLC


DOCUMENTATION REGARDING BANK STABILITY RECONSTRUCTION ALONG THE MISSISSIPPI RIVER
AND SUPPLEMENTAL DOCUMENTATION REGARDING EXISTING DEMOLITION WORK AREA
LOCATED IN SECTION 39, T12S-R07E
ST. JOHN THE BAPTIST PARISH, LOUISIANA

THESE PLATS ARE TO BE USED EXCLUSIVELY FOR
THE ACQUISITION OF REGULATORY PERMITS.

NOTES:





T. BAKER SMITH
PROFESSIONAL CONSULTANTS SINCE 1913
(985) 868-1050 www.tbsmith.com

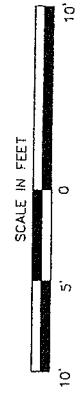

SHEET	6	OF	12
DRAWN BY:	SPM		
APPROVED BY:	KJB		
SCALE:	1"= 10'		
DATE:	07/20/2011		
JOB NUMBER:	2011.0067		

FILE:

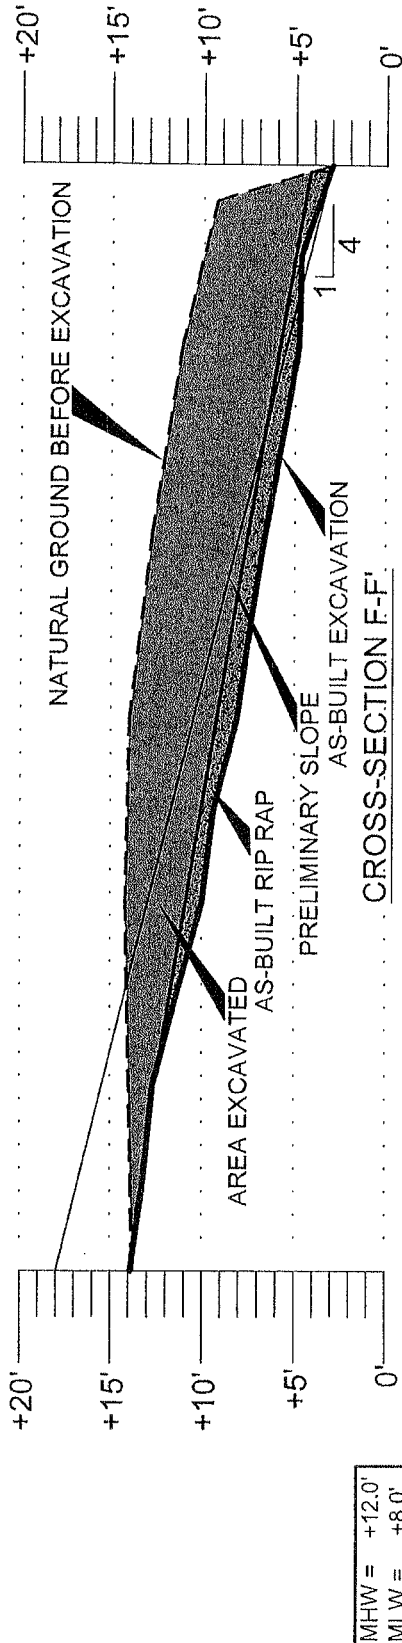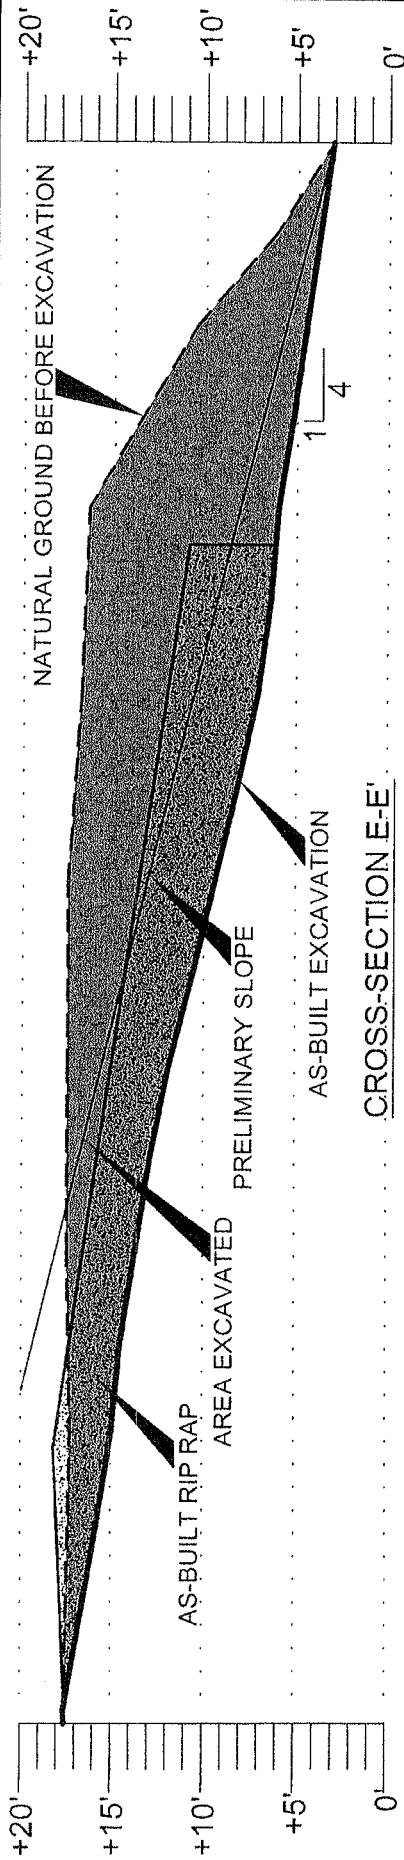

MHW = +12.0'
MLW = +8.0'

REVISION

PROFILE VIEW

ARCELOR MITTAL LAPLACE, LLC


DOCUMENTATION REGARDING BANK STABILITY RECONSTRUCTION ALONG THE MISSISSIPPI RIVER
AND SUPPLEMENTAL DOCUMENTATION REGARDING EXISTING DEMOLITION WORK AREA
LOCATED IN SECTION 39, T12S-R07E
ST. JOHN THE BAPTIST PARISH, LOUISIANA

THESE PLATS ARE TO BE USED EXCLUSIVELY FOR
THE ACQUISITION OF REGULATORY PERMITS.

NOTES:





T. BAKER SMITH
PROFESSIONAL CONSULTANTS SINCE 1913
(985) 858-1050 www.tbsmith.com

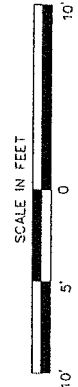


SHEET	7	OF	12
DRAWN BY:	SPM		
APPROVED BY:	KJB		
SCALE:	1"= 10'		
DATE:	07/20/2011		
JOB NUMBER:	2011.0067		

FILE:

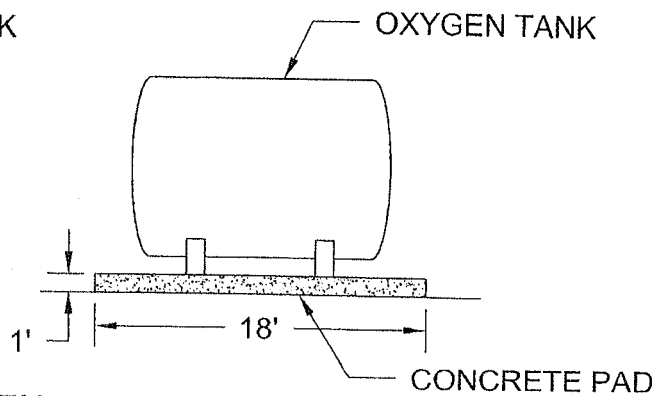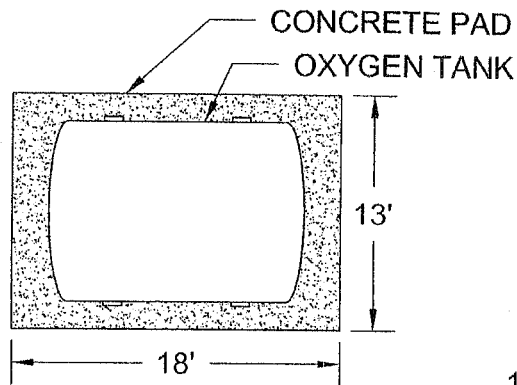

EXISTING OXYGEN TANK DETAIL


TEMPORARY STEEL
PLATE LOCATION
(20'x20'x1/2")

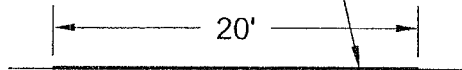

EXISTING DITCH

TEMPORARY STEEL PLATE DETAIL

BARGE WINCH

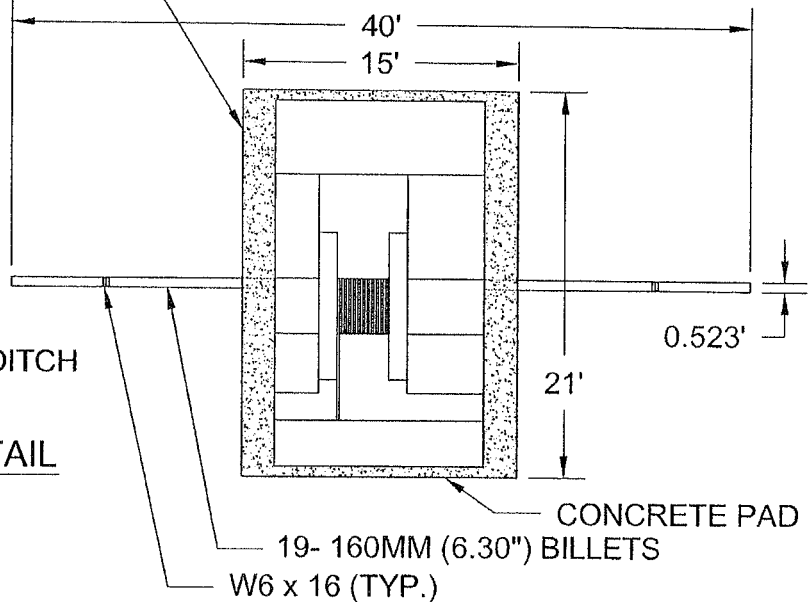

EXISTING WINCH PAD DETAIL

THESE PLATS ARE TO BE USED EXCLUSIVELY FOR
THE ACQUISITION OF REGULATORY PERMITS.

NO.	DATE	REVISION


DETAILS

ARCELOR MITTAL LAPLACE, LLC

DOCUMENTATION REGARDING BANK STABILITY RECONSTRUCTION ALONG THE MISSISSIPPI RIVER
AND SUPPLEMENTAL DOCUMENTATION REGARDING EXISTING DEMOLITION WORK AREA
LOCATED IN SECTION 39, T12S-R07E
ST. JOHN THE BAPTIST PARISH, LOUISIANA





T. BAKER SMITH
PROFESSIONAL CONSULTANTS SINCE 1913
(985) 868-1050 www.tbsmith.com

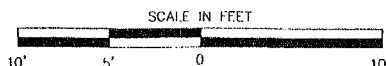

FILE:

SHEET	9	OF	12
DRAWN BY:	SPM		
APPROVED BY:	KJB		
SCALE:	1" = 10'		
DATE:	07/20/2011		
JOB NUMBER:	2011.0067		

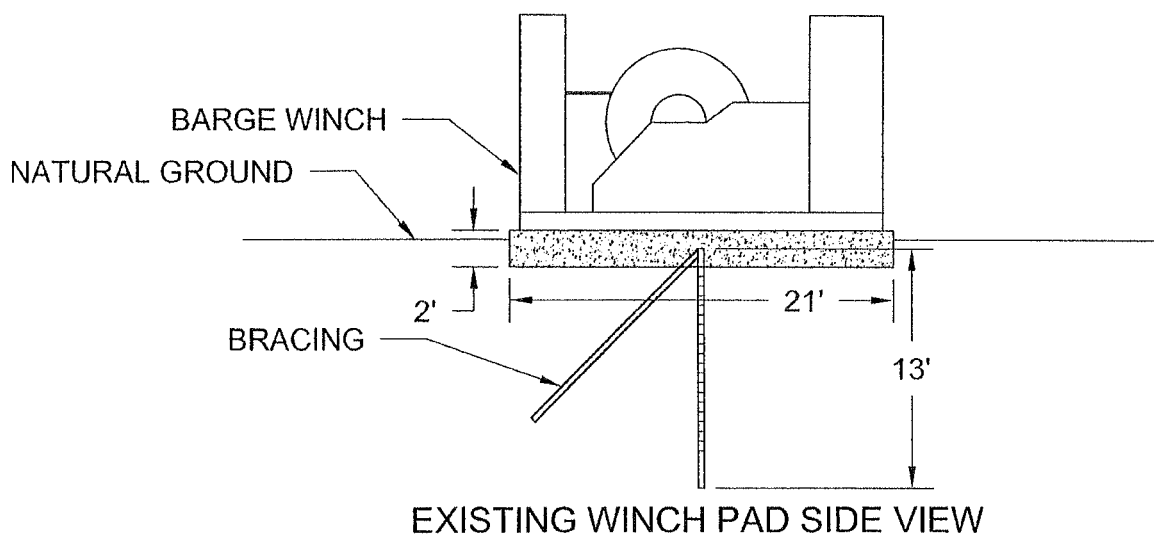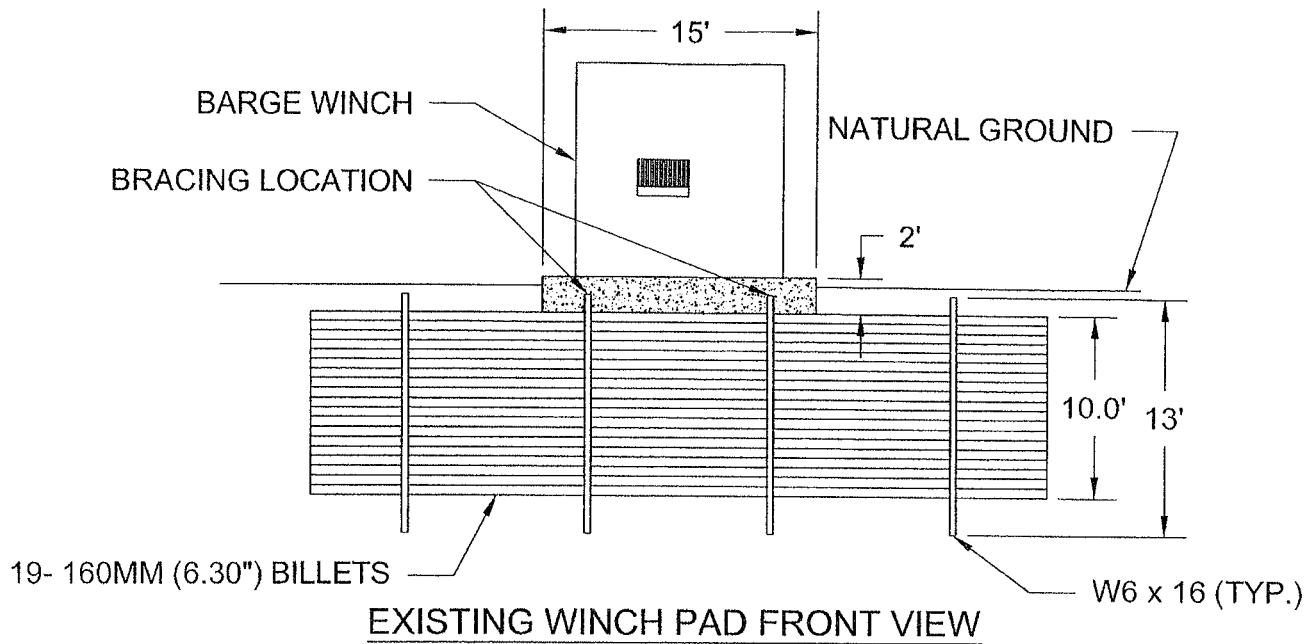

THESE PLATS ARE TO BE USED EXCLUSIVELY FOR
THE ACQUISITION OF REGULATORY PERMITS.

NO.	DATE	REVISION
-----	------	----------


DETAILS

ARCELOR MITTAL LAPLACE, LLC

DOCUMENTATION REGARDING BANK STABILITY RECONSTRUCTION ALONG THE MISSISSIPPI RIVER
AND SUPPLEMENTAL DOCUMENTATION REGARDING EXISTING DEMOLITION WORK AREA
LOCATED IN SECTION 39, T12S-R07E
ST. JOHN THE BAPTIST PARISH, LOUISIANA



T. BAKER SMITH
PROFESSIONAL CONSULTANTS SINCE 1913
(985) 868-1050 www.tbsmith.com

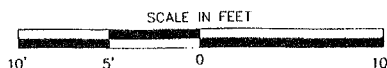

FILE:

SHEET	10	OF	12
DRAWN BY:	SPM		
APPROVED BY:	KJB		
SCALE:	1"= 10'		
DATE:	07/20/2011		
JOB NUMBER:	2011.0067		

Yard Layout Structures

- A: Portable Shelter 60'x35'
- B: Portable Shelter 39'x27'
- C: Portable Shelter 10'x7'
- D: Portable Shelter 10'x7'
- E: Portable Shelter 33'x31'
- F: Portable Shelter 21'x14'
- G: Propane Tank 15'x3'
- H: Portable Shelter 8'x12'
- I: Oxygen Tank on Slab 18'x13'
- J: Barge Winch with Foundation 21'x15'
- K: Barge Winch with Foundation 21'x15'
- L: Portable Shelter 8'x12'
- M: Port-a-pottie

THESE PLATS ARE TO BE USED EXCLUSIVELY FOR
THE ACQUISITION OF REGULATORY PERMITS.

NO.	DATE	REVISION
-----	------	----------

YARD LAYOUT STRUCTURES LEGEND

ARCELOR MITTAL LAPLACE, LLC

DOCUMENTATION REGARDING BANK STABILITY RECONSTRUCTION ALONG THE MISSISSIPPI RIVER
AND SUPPLEMENTAL DOCUMENTATION REGARDING EXISTING DEMOLITION WORK AREA
LOCATED IN SECTION 39, T12S-R07E
ST. JOHN THE BAPTIST PARISH, LOUISIANA



T. BAKER SMITH
PROFESSIONAL CONSULTANTS SINCE 1913
(985) 868-1050 www.tbamth.com

FILE:

SHEET	12	OF	12
DRAWN BY:	SPM		
APPROVED BY:	KJB		
SCALE:	N.T.S.		
DATE:	07/20/2011		
JOB NUMBER:	2011.0067		